


\* 1,500 total spectators Racer + Limit to parking Allowance Staff

\* Staff parking at Lot #8 Driveway

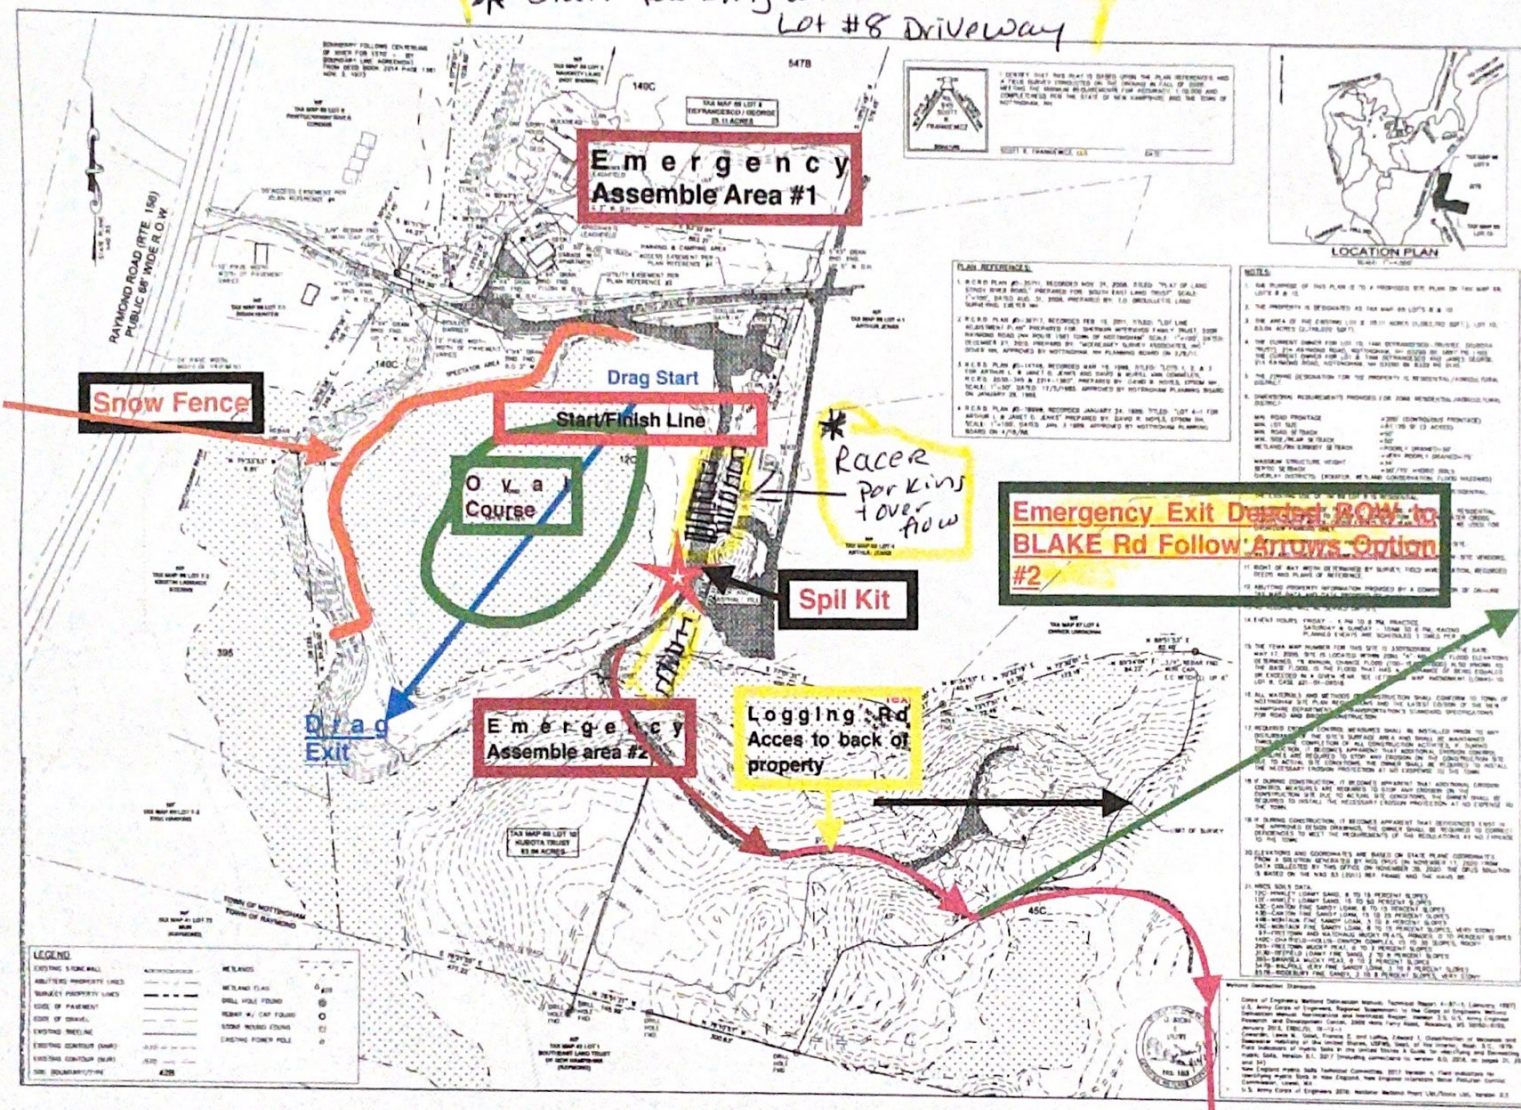

Emergency Exit- Follow Arrows Through Logging Trail-Selt Option #1

**REVISIONS**

NO.	DATE	DESCRIPTION
1		
2		
3		
4		
5		
6		
7		
8		
9		
10		

**CREATING**

SCALE: 1" = 100'

**N.H. LAND Consultants**  
A National Client Company

**EXISTING CONDITIONS PLAN**  
ALABAMA TRUST LOT 10  
TAMI LEE DEFRANCE, TRUSTEE  
214 N. HANCOCK BLVD. SUITE 200  
ANN ARBOR, MI 48106  
TAMI LEE DEFRANCE & JAMES GEORGE  
P.L.L.C.  
ANN ARBOR, MI 48106

**ROCKINGHAM CO**  
JOB NO: 312.00  
DATE: JANUARY 26, 2021  
ECP  
SHEET 2 OF 4



# Defrancesco and SELT lands



## Legend

- Parcels
  - Parcel Polygons
  - Attributes for Additional Lines
- State
- County
- City/Town
- Conservation and Public Land

Map Scale

1: 10,900

© NH GRANIT, [www.granit.unh.edu](http://www.granit.unh.edu)

Map Generated: 8/12/2021



## Notes

